


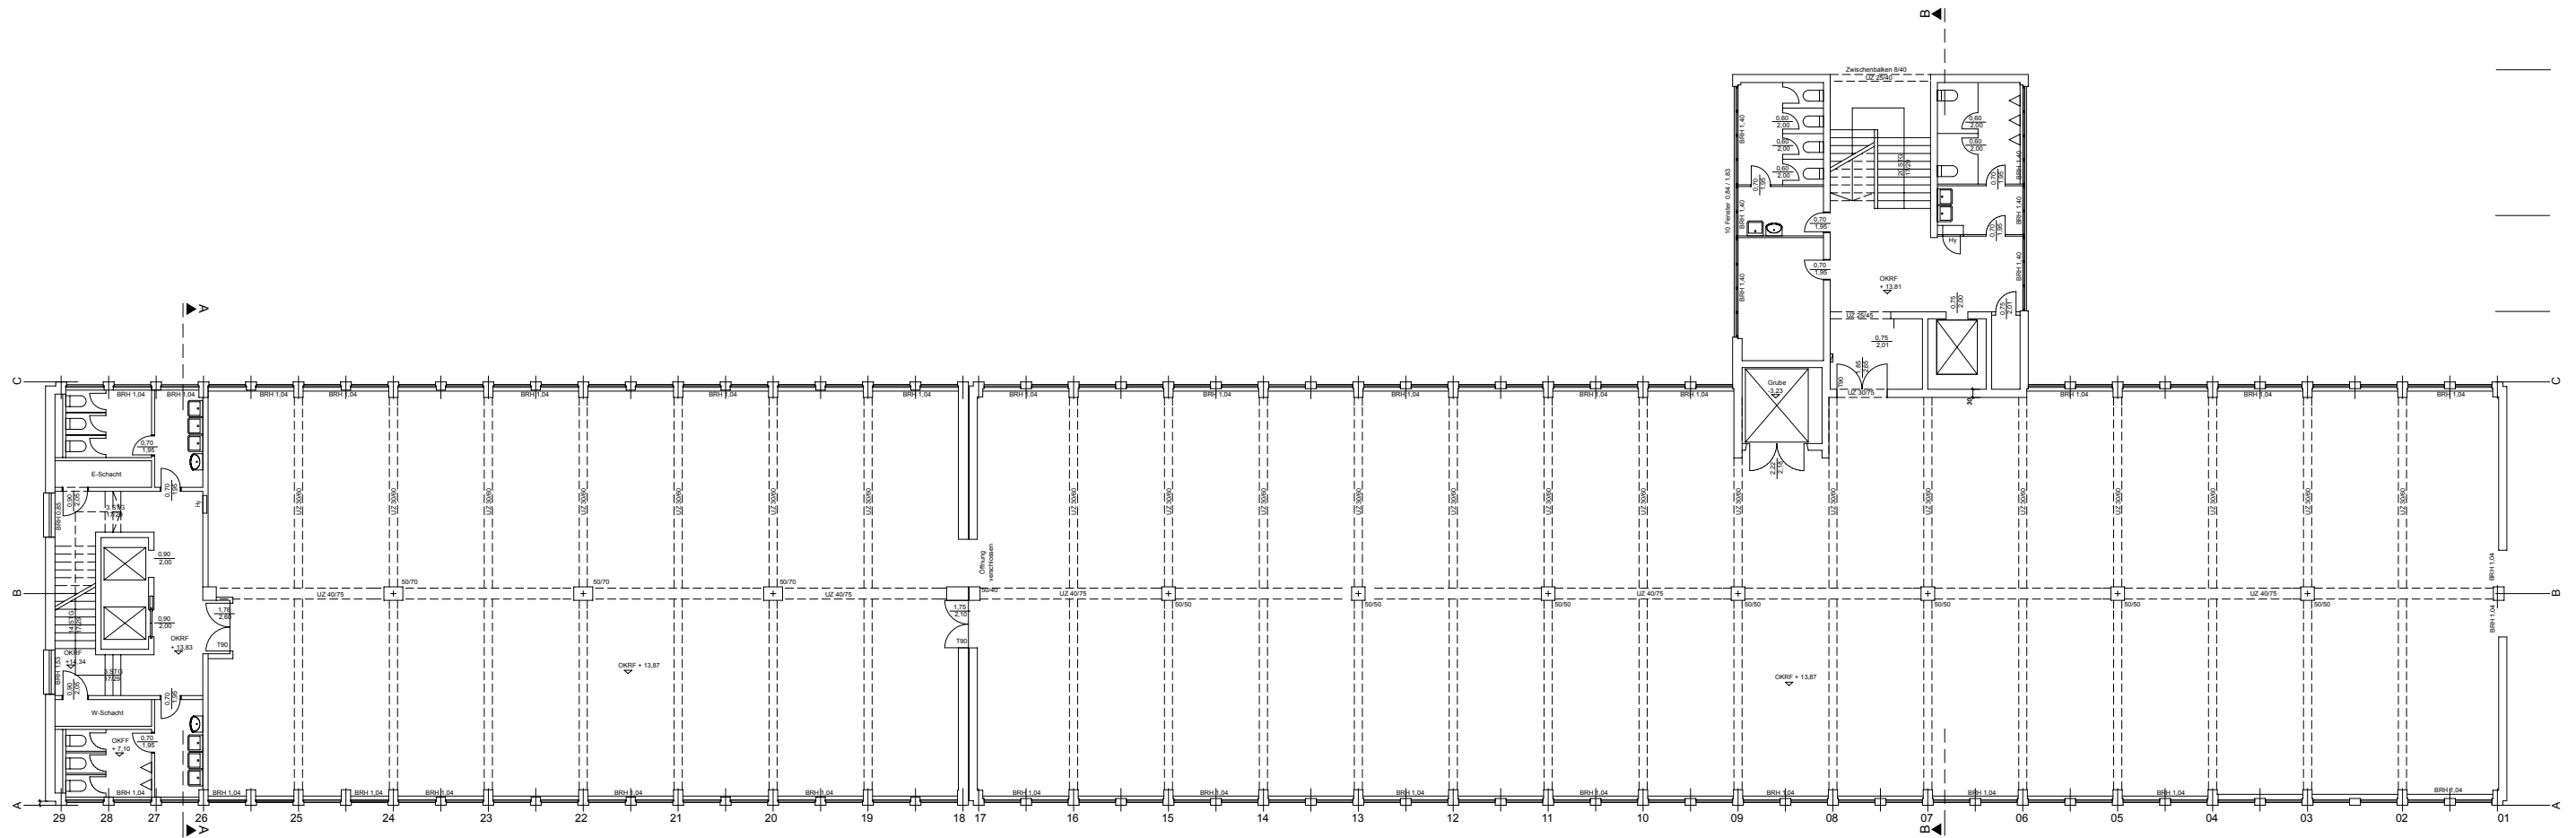

Haus 3 Bestandsplan
4.OG
M 1:250